

EXHIBIT B UTILITY DESIGN SHEET

PROJECT IM 0252-423

Utility Co. #

Conflict #

W-01

Utility Owner: Colorado Springs Utilities Water

X Public

☐ Private**SECTION TO BE COMPLETED PRIOR TO NEGOTIATION MEETING****Existing Condition** See Utility Map for conflicts to W-01

- General Location _____
- Utility type: ☐ Electric ☐ Gas ☐ Communications ☒ Water ☐ Sanitary ☐ Cable TV ☐ Irr. Canal
☐ Other _____
- Location by: ☐ Utility plat maps; Field located and surveyed: ☒ Yes ☐ No; Pothole: ☐ Yes ☐ No
If pothole, # _____ from: ☐ CDOT pothole or ☐ DBC pothole HCL used: _____
Station: 115+ to Station: 115+ Dist. from HCL: _____ Rt. / Lt. _____
- Utility size & type of materials: 24" DIP NP line crossing I-25 in 36" steel casing.
- Environmental Concerns: _____
- Encased: ☐ No ☒ Yes, if so size & material: 36" Steel
This section completed by DBC Rep.: _____ Date: _____

SECTION TO BE COMPLETED AT NEGOTIATION MEETING**Proposed Resolution**

- Recommendation: ☐ left alone ☐ modified ☐ removed ☐ relocated ☐ upgraded ☐ abandoned in place
Conflict with: _____
- This utility may be modified/relocated to: _____
Station: _____ to Station: _____ Dist. from HCL: _____ Rt./Lt. _____
- Utility in: ☐ CDOT ROW ☐ other public ROW ☐ Easement (attach copy) ☐ other _____
- Who will do the Utility Relocation Plan: ☐ Utility Company (UC) ☐ Design/Build Contractor (DBC)
- Who will do the construction: ☐ Utility Company (UC) ☐ Design/Build Contractor (DBC)
- UC to perform inspection? ☐ No ☐ Yes, if so conditions: _____
- Number of days required for prior notification by DBC for construction by UC: _____ days
- Number of days required by UC or DBC to complete Utility Relocation Plan: _____ days; Construction: _____ days.
- Any construction details unique to this location? ☐ No ☐ Yes, if yes describe: _____
- Utility can be disconnected for: _____ days/hours.
- Other proposed action: _____
- Contractor Drawings confirming conflict must be attached
This section completed by: Utility Co. _____ Date: _____ DBC _____ Date: _____

EXHIBIT B UTILITY DESIGN SHEET**PROJECT IM 0252-423**

Utility Co. #

Conflict #

W-02

Utility Owner: Colorado Springs Utilities Water

X Public

☐ Private**SECTION TO BE COMPLETED PRIOR TO NEGOTIATION MEETING****Existing Condition** See Utility Map for conflicts to W-02

1. General Location _____
2. Utility type: ☐ Electric ☐ Gas ☐ Communications ☒ Water ☐ Sanitary ☐ Cable TV ☐ Irr. Canal
☐ Other _____
3. Location by: ☐ Utility plat maps; Field located and surveyed: ☒ Yes ☐ No; Pothole: ☐ Yes ☐ No
If pothole, # _____ from: ☐ CDOT pothole or ☐ DBC pothole HCL used: _____
Station: 115+ to Station: 115+ Dist. from HCL: _____ Rt. / Lt. _____
4. Utility size & type of materials: 6" CIP at Abbott Ln.
5. Environmental Concerns: _____
6. Encased: ☐ No ☒ Yes, if so size & material: 36" Steel
This section completed by DBC Rep.: _____ Date: _____

SECTION TO BE COMPLETED AT NEGOTIATION MEETING**Proposed Resolution**

1. Recommendation: ☐ left alone ☐ modified ☐ removed ☐ relocated ☐ upgraded ☐ abandoned in place
Conflict with: _____
2. This utility may be modified/relocated to: _____
Station: _____ to Station: _____ Dist. from HCL: _____ Rt./Lt. _____
3. Utility in: ☐ CDOT ROW ☐ other public ROW ☐ Easement (attach copy) ☐ other _____
4. Who will do the Utility Relocation Plan: ☐ Utility Company (UC) ☐ Design/Build Contractor (DBC)
5. Who will do the construction: ☐ Utility Company (UC) ☐ Design/Build Contractor (DBC)
6. UC to perform inspection? ☐ No ☐ Yes, if so conditions: _____
7. Number of days required for prior notification by DBC for construction by UC: _____ days
8. Number of days required by UC or DBC to complete Utility Relocation Plan: _____ days; Construction: _____ days.
9. Any construction details unique to this location? ☐ No ☐ Yes, if yes describe: _____
10. Utility can be disconnected for: _____ days/hours.
11. Other proposed action: _____
12. Contractor Drawings confirming conflict must be attached
This section completed by: Utility Co. _____ Date: _____ DBC _____ Date: _____

EXHIBIT B UTILITY DESIGN SHEET**PROJECT IM 0252-423**

Utility Co. #

Conflict #

W-03

Utility Owner: Colorado Springs Utilities Water

X Public

☐ Private**SECTION TO BE COMPLETED PRIOR TO NEGOTIATION MEETING****Existing Condition** See Utility Map for conflicts to W-03

- General Location _____
- Utility type: ☐ Electric ☐ Gas ☐ Communications ☒ Water ☐ Sanitary ☐ Cable TV ☐ Irr. Canal
☐ Other _____
- Location by: ☐ Utility plat maps; Field located and surveyed: ☒ Yes ☐ No; Pothole: ☐ Yes ☐ No
If pothole, # _____ from: ☐ CDOT pothole or ☐ DBC pothole HCL used: _____
Station: 719+ to Station: 720+ Dist. from HCL: Crossing Rt. / Lt.
- Utility size & type of materials: 6" CIP crossing Cimarron St
- Environmental Concerns: _____
- Encased: ☐ No ☒ Yes, if so size & material: 180' Sleeve
This section completed by DBC Rep.: _____ Date: _____

SECTION TO BE COMPLETED AT NEGOTIATION MEETING**Proposed Resolution**

- Recommendation: ☐ left alone ☐ modified ☐ removed ☐ relocated ☐ upgraded ☐ abandoned in place
Conflict with: _____
- This utility may be modified/relocated to: _____
Station: _____ to Station: _____ Dist. from HCL: _____ Rt./Lt. _____
- Utility in: ☐ CDOT ROW ☐ other public ROW ☐ Easement (attach copy) ☐ other _____
- Who will do the Utility Relocation Plan: ☐ Utility Company (UC) ☐ Design/Build Contractor (DBC)
- Who will do the construction: ☐ Utility Company (UC) ☐ Design/Build Contractor (DBC)
- UC to perform inspection? ☐ No ☐ Yes, if so conditions: _____
- Number of days required for prior notification by DBC for construction by UC: _____ days
- Number of days required by UC or DBC to complete Utility Relocation Plan: _____ days; Construction: _____ days.
- Any construction details unique to this location? ☐ No ☐ Yes, if yes describe: _____
- Utility can be disconnected for: _____ days/hours.
- Other proposed action: _____
- Contractor Drawings confirming conflict must be attached
This section completed by: Utility Co. _____ Date: _____ DBC _____ Date: _____

EXHIBIT B UTILITY DESIGN SHEET

PROJECT IM 0252-423

Utility Co. #

Conflict #

W-04

Utility Owner: Colorado Springs Utilities Water

X Public

☐ Private**SECTION TO BE COMPLETED PRIOR TO NEGOTIATION MEETING****Existing Condition** See Utility Map for conflicts to W-04

1. General Location _____
2. Utility type: ☐ Electric ☐ Gas ☐ Communications ☒ Water ☐ Sanitary ☐ Cable TV ☐ Irr. Canal
☐ Other _____
3. Location by: ☐ Utility plat maps; Field located and surveyed: ☒ Yes ☐ No; Pothole: ☐ Yes ☐ No
If pothole, # _____ from: ☐ CDOT pothole or ☐ DBC pothole HCL used: _____
Station: 122+ to Station: 132+ Dist. from HCL: _____ Rt. / Lt. RT
4. Utility size & type of materials: 16" DIP Non Pot line
5. Environmental Concerns: _____
6. Encased: ☐ No ☐ Yes, if so size & material: _____
This section completed by DBC Rep.: _____ Date: _____

SECTION TO BE COMPLETED AT NEGOTIATION MEETING**Proposed Resolution**

1. Recommendation: ☐ left alone ☐ modified ☐ removed ☐ relocated ☐ upgraded ☐ abandoned in place
Conflict with: _____
2. This utility may be modified/relocated to: _____
Station: _____ to Station: _____ Dist. from HCL: _____ Rt./Lt. _____
3. Utility in: ☐ CDOT ROW ☐ other public ROW ☐ Easement (attach copy) ☐ other _____
4. Who will do the Utility Relocation Plan: ☐ Utility Company (UC) ☐ Design/Build Contractor (DBC)
5. Who will do the construction: ☐ Utility Company (UC) ☐ Design/Build Contractor (DBC)
6. UC to perform inspection? ☐ No ☐ Yes, if so conditions: _____
7. Number of days required for prior notification by DBC for construction by UC: _____ days
8. Number of days required by UC or DBC to complete Utility Relocation Plan: _____ days; Construction: _____ days.
9. Any construction details unique to this location? ☐ No ☐ Yes, if yes describe: _____
10. Utility can be disconnected for: _____ days/hours.
11. Other proposed action: _____
12. Contractor Drawings confirming conflict must be attached
This section completed by: Utility Co. _____ Date: _____ DBC _____ Date: _____

EXHIBIT B UTILITY DESIGN SHEET**PROJECT IM 0252-423**

Utility Co. #

Conflict #

W-05

Utility Owner: Colorado Springs Utilities Water

X Public

☐ Private**SECTION TO BE COMPLETED PRIOR TO NEGOTIATION MEETING****Existing Condition** See Utility Map for conflicts to W-05

1. General Location _____
2. Utility type: ☐ Electric ☐ Gas ☐ Communications ☒ Water ☐ Sanitary ☐ Cable TV ☐ Irr. Canal
☐ Other _____
3. Location by: ☐ Utility plat maps; Field located and surveyed: ☒ Yes ☐ No; Pothole: ☐ Yes ☐ No
If pothole, # _____ from: ☐ CDOT pothole or ☐ DBC pothole HCL used: _____
Station: 131+ to Station: 142+ Dist. from HCL: _____ Rt. / Lt. RT
4. Utility size & type of material 8" CIP from Colorado Ave. to Cimarron St.
5. Environmental Concerns: _____
6. Encased: ☒ No ☐ Yes, if so size & material: _____
This section completed by DBC Rep.: _____ Date: _____

SECTION TO BE COMPLETED AT NEGOTIATION MEETING**Proposed Resolution**

1. Recommendation: ☐ left alone ☐ modified ☐ removed ☐ relocated ☐ upgraded ☐ abandoned in place
Conflict with: _____
2. This utility may be modified/relocated to: _____
Station: _____ to Station: _____ Dist. from HCL: _____ Rt./Lt. _____
3. Utility in: ☐ CDOT ROW ☐ other public ROW ☐ Easement (attach copy) ☐ other _____
4. Who will do the Utility Relocation Plan: ☐ Utility Company (UC) ☐ Design/Build Contractor (DBC)
5. Who will do the construction: ☐ Utility Company (UC) ☐ Design/Build Contractor (DBC)
6. UC to perform inspection? ☐ No ☐ Yes, if so conditions: _____
7. Number of days required for prior notification by DBC for construction by UC: _____ days
8. Number of days required by UC or DBC to complete Utility Relocation Plan: _____ days; Construction: _____ days.
9. Any construction details unique to this location? ☐ No ☐ Yes, if yes describe: _____
10. Utility can be disconnected for: _____ days/hours.
11. Other proposed action: _____
12. Contractor Drawings confirming conflict must be attached
This section completed by: Utility Co. _____ Date: _____ DBC _____ Date: _____

EXHIBIT B UTILITY DESIGN SHEET**PROJECT IM 0252-423**

Utility Co. #

Conflict #

W-06

Utility Owner: Colorado Springs Utilities Water

X Public

☐ Private**SECTION TO BE COMPLETED PRIOR TO NEGOTIATION MEETING****Existing Condition** See Utility Map for conflicts to W-06

1. General Location _____
2. Utility type: ☐ Electric ☐ Gas ☐ Communications ☒ Water ☐ Sanitary ☐ Cable TV ☐ Irr. Canal
☐ Other _____
3. Location by: ☐ Utility plat maps; Field located and surveyed: ☒ Yes ☐ No; Pothole: ☐ Yes ☐ No
If pothole, # _____ from: ☐ CDOT pothole or ☐ DBC pothole HCL used: _____
Station: 100+ _____ to Station: 108+ _____ Dist. from HCL: _____ Rt. / Lt. _____
4. Utility size & type of materials: 16" DIP Non Pot line
5. Environmental Concerns: _____
6. Encased: ☒ No ☐ Yes, if so size & material: _____
This section completed by DBC Rep.: _____ Date: _____

SECTION TO BE COMPLETED AT NEGOTIATION MEETING**Proposed Resolution**

1. Recommendation: ☐ left alone ☐ modified ☐ removed ☐ relocated ☐ upgraded ☐ abandoned in place
Conflict with: _____
2. This utility may be modified/relocated to: _____
Station: _____ to Station: _____ Dist. from HCL: _____ Rt./Lt. _____
3. Utility in: ☐ CDOT ROW ☐ other public ROW ☐ Easement (attach copy) ☐ other _____
4. Who will do the Utility Relocation Plan: ☐ Utility Company (UC) ☐ Design/Build Contractor (DBC)
5. Who will do the construction: ☐ Utility Company (UC) ☐ Design/Build Contractor (DBC)
6. UC to perform inspection? ☐ No ☐ Yes, if so conditions: _____
7. Number of days required for prior notification by DBC for construction by UC: _____ days
8. Number of days required by UC or DBC to complete Utility Relocation Plan: _____ days; Construction: _____ days.
9. Any construction details unique to this location? ☐ No ☐ Yes, if yes describe: _____
10. Utility can be disconnected for: _____ days/hours.
11. Other proposed action: _____
12. Contractor Drawings confirming conflict must be attached
This section completed by: Utility Co. _____ Date: _____ DBC _____ Date: _____

EXHIBIT B UTILITY DESIGN SHEET

PROJECT IM 0252-423

Utility Co. #

Conflict #

W-07

Utility Owner: Colorado Springs Utilities Water

X Public

☐ Private**SECTION TO BE COMPLETED PRIOR TO NEGOTIATION MEETING****Existing Condition** See Utility Map for conflicts to W-07 (A.R.E.)

1. General Location _____
2. Utility type: ☐ Electric ☐ Gas ☐ Communications ☒ Water ☐ Sanitary ☐ Cable TV ☐ Irr. Canal
☐ Other _____
3. Location by: ☐ Utility plat maps; Field located and surveyed: ☒ Yes ☐ No; Pothole: ☐ Yes ☐ No
If pothole, # _____ from: ☐ CDOT pothole or ☐ DBC pothole HCL used: _____
Station: 712+ to Station: 714+ Dist. from HCL: Crossing Rt. / Lt.
4. Utility size & type of materials: 36" DIP Non Pot line
5. Environmental Concerns: _____
6. Encased: ☐ No ☒ Yes, if so size & material: 48"
This section completed by DBC Rep.: _____ Date: _____

SECTION TO BE COMPLETED AT NEGOTIATION MEETING**Proposed Resolution**

1. Recommendation: ☐ left alone ☐ modified ☐ removed ☐ relocated ☐ upgraded ☐ abandoned in place
Conflict with: _____
2. This utility may be modified/relocated to: _____
Station: _____ to Station: _____ Dist. from HCL: _____ Rt./Lt. _____
3. Utility in: ☐ CDOT ROW ☐ other public ROW ☐ Easement (attach copy) ☐ other _____
4. Who will do the Utility Relocation Plan: ☐ Utility Company (UC) ☐ Design/Build Contractor (DBC)
5. Who will do the construction: ☐ Utility Company (UC) ☐ Design/Build Contractor (DBC)
6. UC to perform inspection? ☐ No ☐ Yes, if so conditions: _____
7. Number of days required for prior notification by DBC for construction by UC: _____ days
8. Number of days required by UC or DBC to complete Utility Relocation Plan: _____ days; Construction: _____ days.
9. Any construction details unique to this location? ☐ No ☐ Yes, if yes describe: _____
10. Utility can be disconnected for: _____ days/hours.
11. Other proposed action: _____
12. Contractor Drawings confirming conflict must be attached
This section completed by: Utility Co. _____ Date: _____ DBC _____ Date: _____

EXHIBIT B UTILITY DESIGN SHEET**PROJECT IM 0252-423**

Utility Co. #

Conflict #

W-08

Utility Owner: Colorado Springs Utilities Water

X Public


☐ Private**SECTION TO BE COMPLETED PRIOR TO NEGOTIATION MEETING****Existing Condition** See Utility Map for conflicts to W-08 (A.R.E.)

1. General Location _____
2. Utility type: ☐ Electric ☐ Gas ☐ Communications ☒ Water ☐ Sanitary ☐ Cable TV ☐ Irr. Canal
☐ Other _____
3. Location by: ☐ Utility plat maps; Field located and surveyed: ☒ Yes ☐ No; Pothole: ☐ Yes ☐ No
If pothole, # _____ from: ☐ CDOT pothole or ☐ DBC pothole HCL used: _____
Station: 712+ to Station: 714+ Dist. from HCL: Crossing Rt. / Lt.
4. Utility size & type of materials: 42" Water line
5. Environmental Concerns: _____
6. Encased: ☐ No ☒ Yes, if so size & material: 54" Steel
This section completed by DBC Rep.: _____ Date: _____

SECTION TO BE COMPLETED AT NEGOTIATION MEETING**Proposed Resolution**


1. Recommendation: ☐ left alone ☐ modified ☐ removed ☐ relocated ☐ upgraded ☐ abandoned in place
Conflict with: _____
2. This utility may be modified/relocated to: _____
Station: _____ to Station: _____ Dist. from HCL: _____ Rt./Lt. _____
3. Utility in: ☐ CDOT ROW ☐ other public ROW ☐ Easement (attach copy) ☐ other _____
4. Who will do the Utility Relocation Plan: ☐ Utility Company (UC) ☐ Design/Build Contractor (DBC)
5. Who will do the construction: ☐ Utility Company (UC) ☐ Design/Build Contractor (DBC)
6. UC to perform inspection? ☐ No ☐ Yes, if so conditions: _____
7. Number of days required for prior notification by DBC for construction by UC: _____ days
8. Number of days required by UC or DBC to complete Utility Relocation Plan: _____ days; Construction: _____ days.
9. Any construction details unique to this location? ☐ No ☐ Yes, if yes describe: _____
10. Utility can be disconnected for: _____ days/hours.
11. Other proposed action: _____
12. Contractor Drawings confirming conflict must be attached
This section completed by: Utility Co. _____ Date: _____ DBC _____ Date: _____

PadillaK 3:44:28 PM pw:\\ABQP\\WINT01\\wilsonco.com\\Wilson_P\\Projects\\Documents\\8100-TRN\\CDOT\\13-100-312-01_125_Cimarron_Interch\\19039\\Utilities Drawings\\Water Site Plan

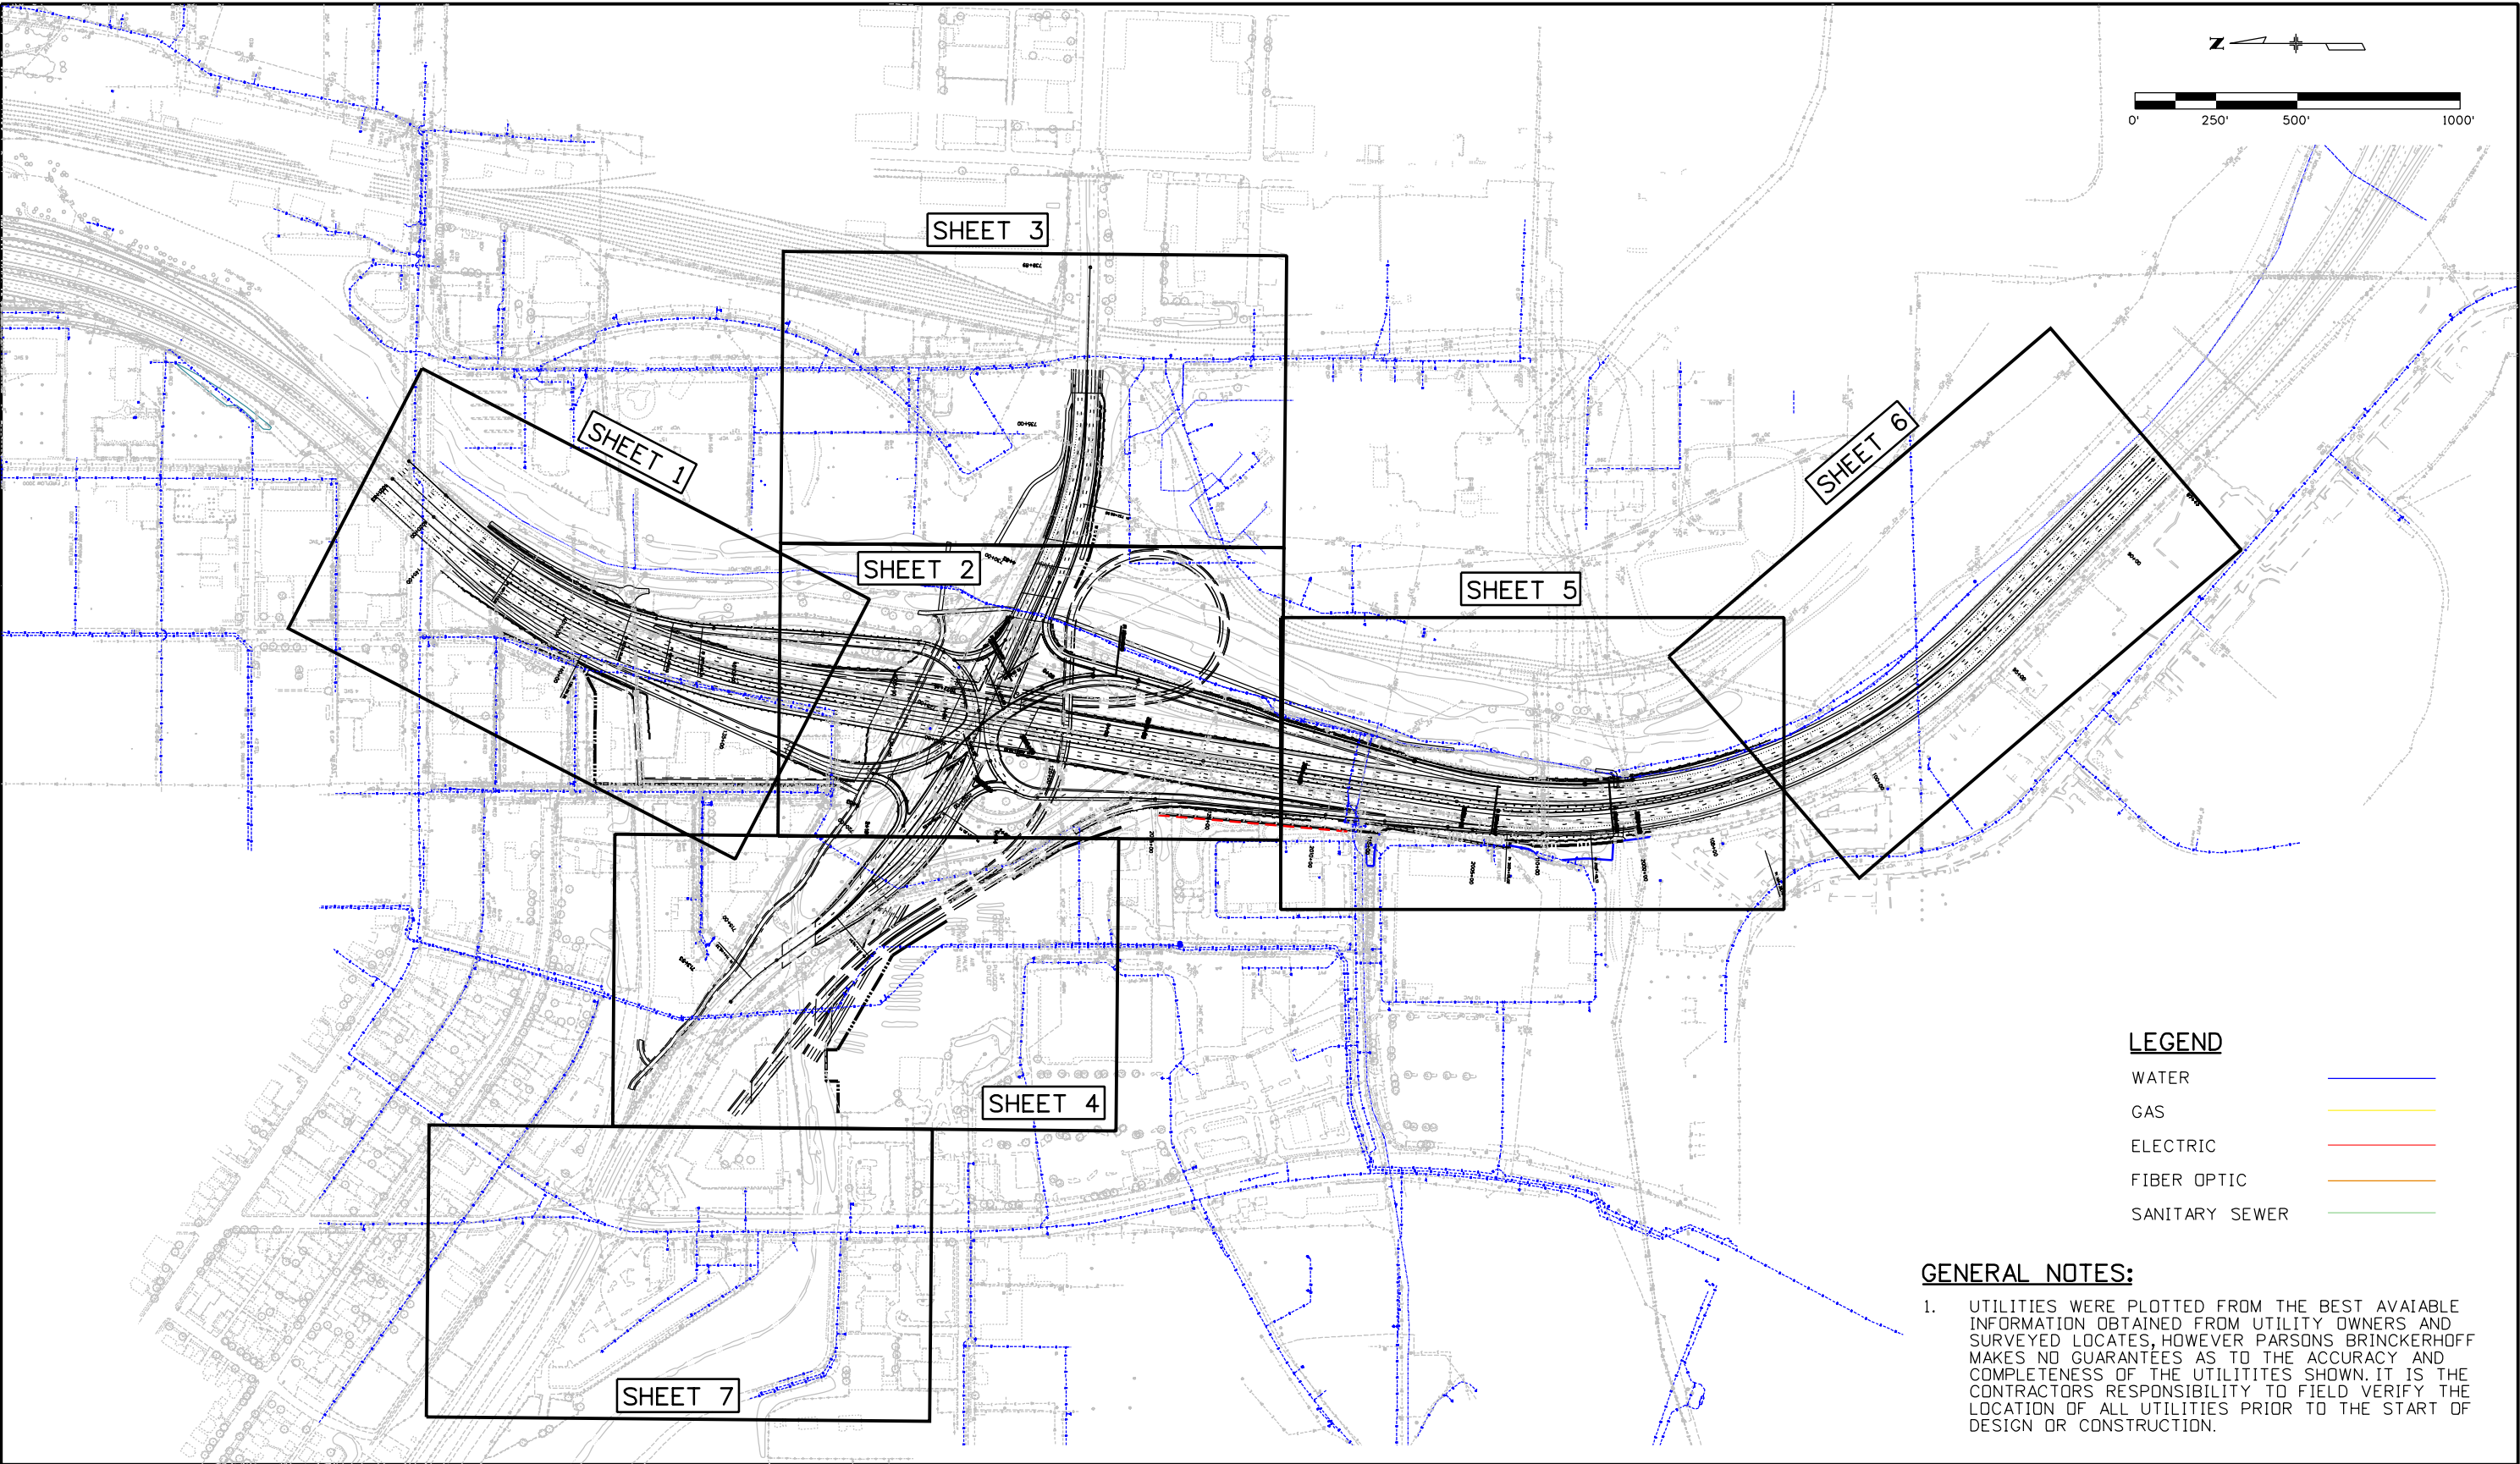

Print Date: 4/17/2014		<div><div></div><div></div><div></div><div></div><div></div></div>	Sheet Revisions			<div><div>Colorado Department of Transportation</div><div>1480 Quail Lake Loop, Suite A Colorado Springs, CO 80906 Phone: 719-634-2323 FAX: 719-227-3298</div><div>Region 2DMW</div></div>	As Constructed		UTILITY WATER SITE PLAN				Project No./Code	
File Name: Water Site Plan			Date:	Comments	Init.		No Revisions:						XXXXXXXXXX423X	
Horiz. Scale: 1:500			Vert. Scale:					Revised:		Designer: XXXXXXXX	Structure Numbers	XXXXXX		
Unit Information			Unit Leader Initials					Void:		Detailer: XXXXXXXX		Sheet Number		
<div><div>PARSONS BRINCKERHOFF</div><div>555 17th Street Suite 500 Denver, CO 80202</div></div>										Subset: _SG	Subset Sheets: _SN of _SD	_ON		

PadillaK 3:01:01 PM pw:\ABOP\W\T01.wilsonco.com\Wilson_P\Projects\Documents\8100-TRN\CDOT\13-100-312-01_125_Cimarron_Interch\Drawings\Water_Sheet 1

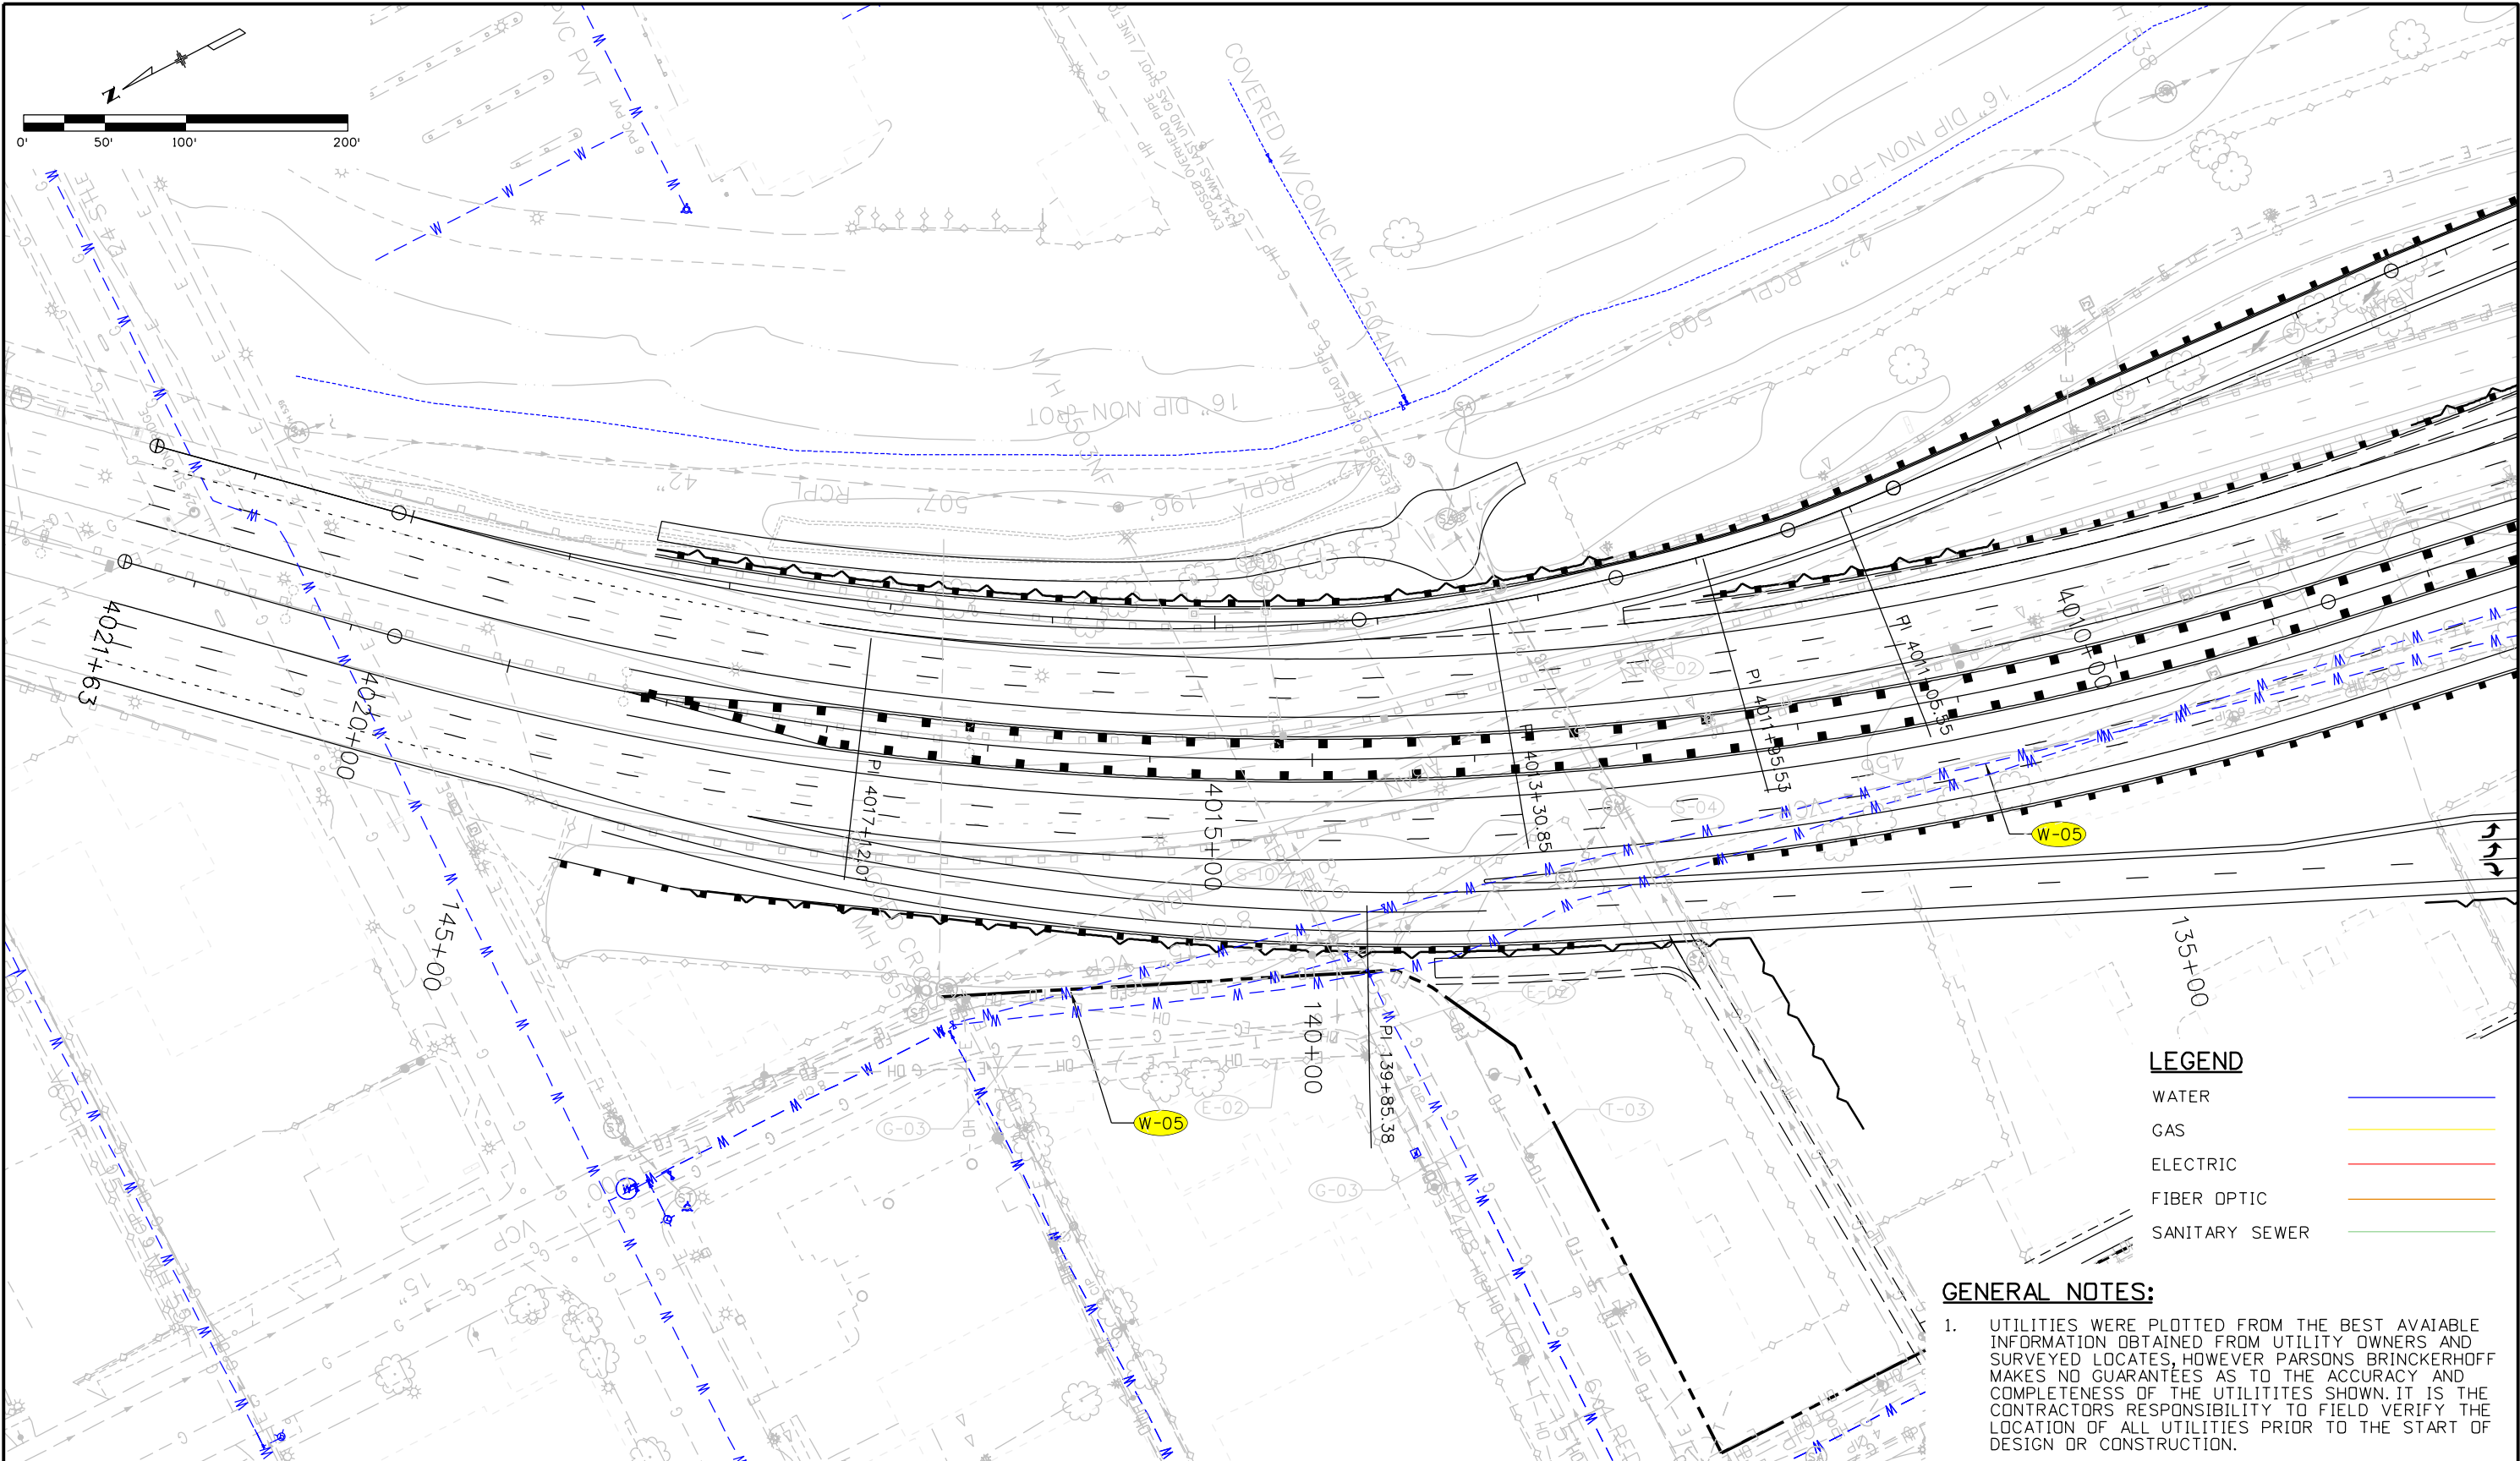


LEGEND


WATER	
GAS	
ELECTRIC	
FIBER OPTIC	
SANITARY SEWER	

GENERAL NOTES:

- UTILITIES WERE PLOTTED FROM THE BEST AVAILABLE INFORMATION OBTAINED FROM UTILITY OWNERS AND SURVEYED LOCATES, HOWEVER PARSONS BRINCKERHOFF MAKES NO GUARANTEES AS TO THE ACCURACY AND COMPLETENESS OF THE UTILITIES SHOWN. IT IS THE CONTRACTORS RESPONSIBILITY TO FIELD VERIFY THE LOCATION OF ALL UTILITIES PRIOR TO THE START OF DESIGN OR CONSTRUCTION.

Print Date: 4/17/2014		<div>R-X</div> <div></div> <div></div> <div></div>	Sheet Revisions			<div><div>Colorado Department of Transportation</div><div>1480 Quail Lake Loop, Suite A Colorado Springs, CO 80906 Phone: 719-634-2323 FAX: 719-227-3298</div><div>Region 2 DMW</div></div>		As Constructed	WATER SHEET 1 OF 7				Project No./Code	
File Name: Water Sheet 1			Date:	Comments	Init.			No Revisions:					IM 0252-423	
Horiz. Scale: 1:100 Vert. Scale:								Revised:	Designer: XXXXXXXX	Structure Numbers	19039			
Unit Information Unit Leader Initials								Void:	Detailer: XXXXXXXX		Sheet Number _ON			
<div><div>PARSONS BRINCKERHOFF</div><div>555 17th Street Suite 500 Denver, CO 80202</div></div>								Subset: _SG	Subset Sheets: _SN of _SD					

PadillaK 3:12:24 PM pw:\ABOPWINT01.wilsonco.com\Wilson_Projects\Documents\8100-TRN\COOT\13-100-312-01_125_Cimarron_Interch\19039\Utilities\Drawings\Water Sheet 2

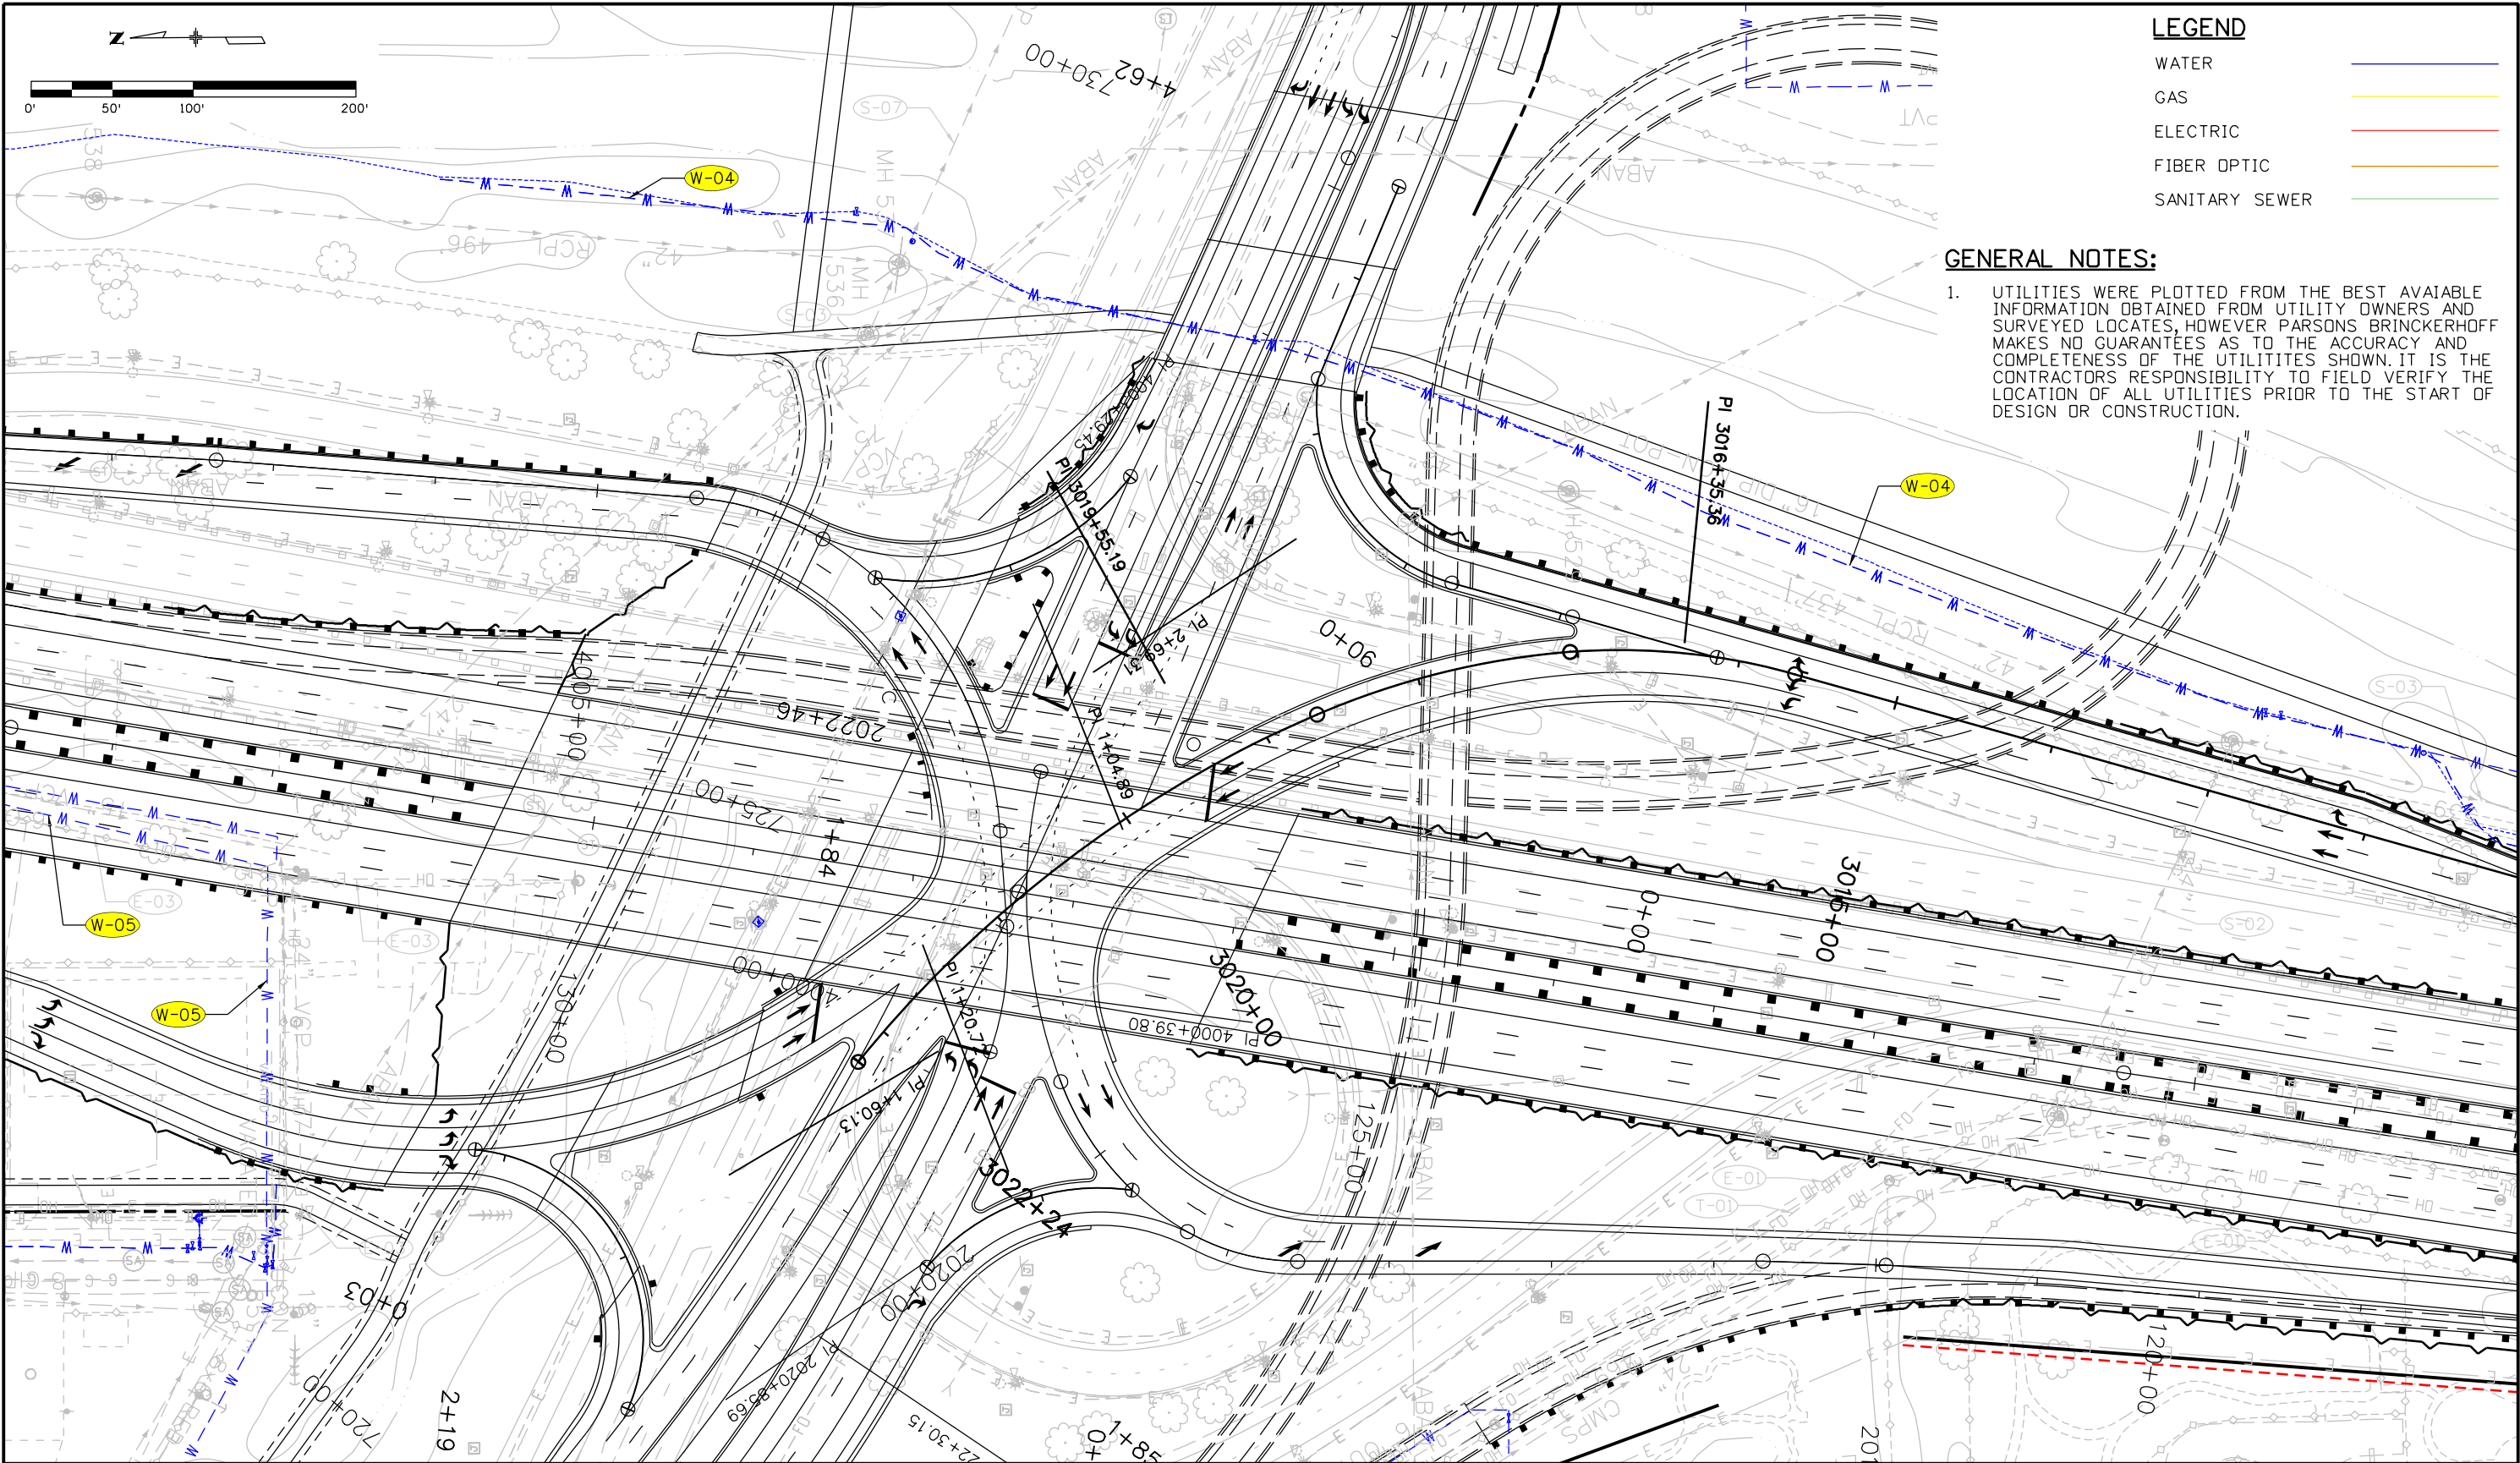

Print Date: 4/17/2014	
File Name: Water Sheet 2	
Horiz. Scale: 1:100	Vert. Scale:
Unit Information	Unit Leader Initials
PARSONS BRINCKERHOFF	
555 17th Street Suite 500 Denver, CO 80202	

Sheet Revisions		
Date:	Comments	Init.




Colorado Department of Transportation
Region 2

1480 Quail Lake Loop, Suite A
Colorado Springs, CO 80906
Phone: 719-634-2323 FAX: 719-227-3298

DMW

As Constructed		WATER SHEET 2 OF 7			Project No./Code	
No Revisions:					IM 0252-423	
Revised:		Designer: XXXXXXXX	Structure Numbers		19039	
Void:		Detailer: XXXXXXXX			Sheet Number _ON	
		Subset: _SG	Subset Sheets: _SN of _SD			

PadillaK 3:16:20 PM pw:\ABOP\WINT01.wilsonco.com\Wilson_Projcts\Documents\8100-TRN\CDOT\13-100-312-01_125_Cimarron_Interch\19039\Utilities\Drawings\Water Sheet 3

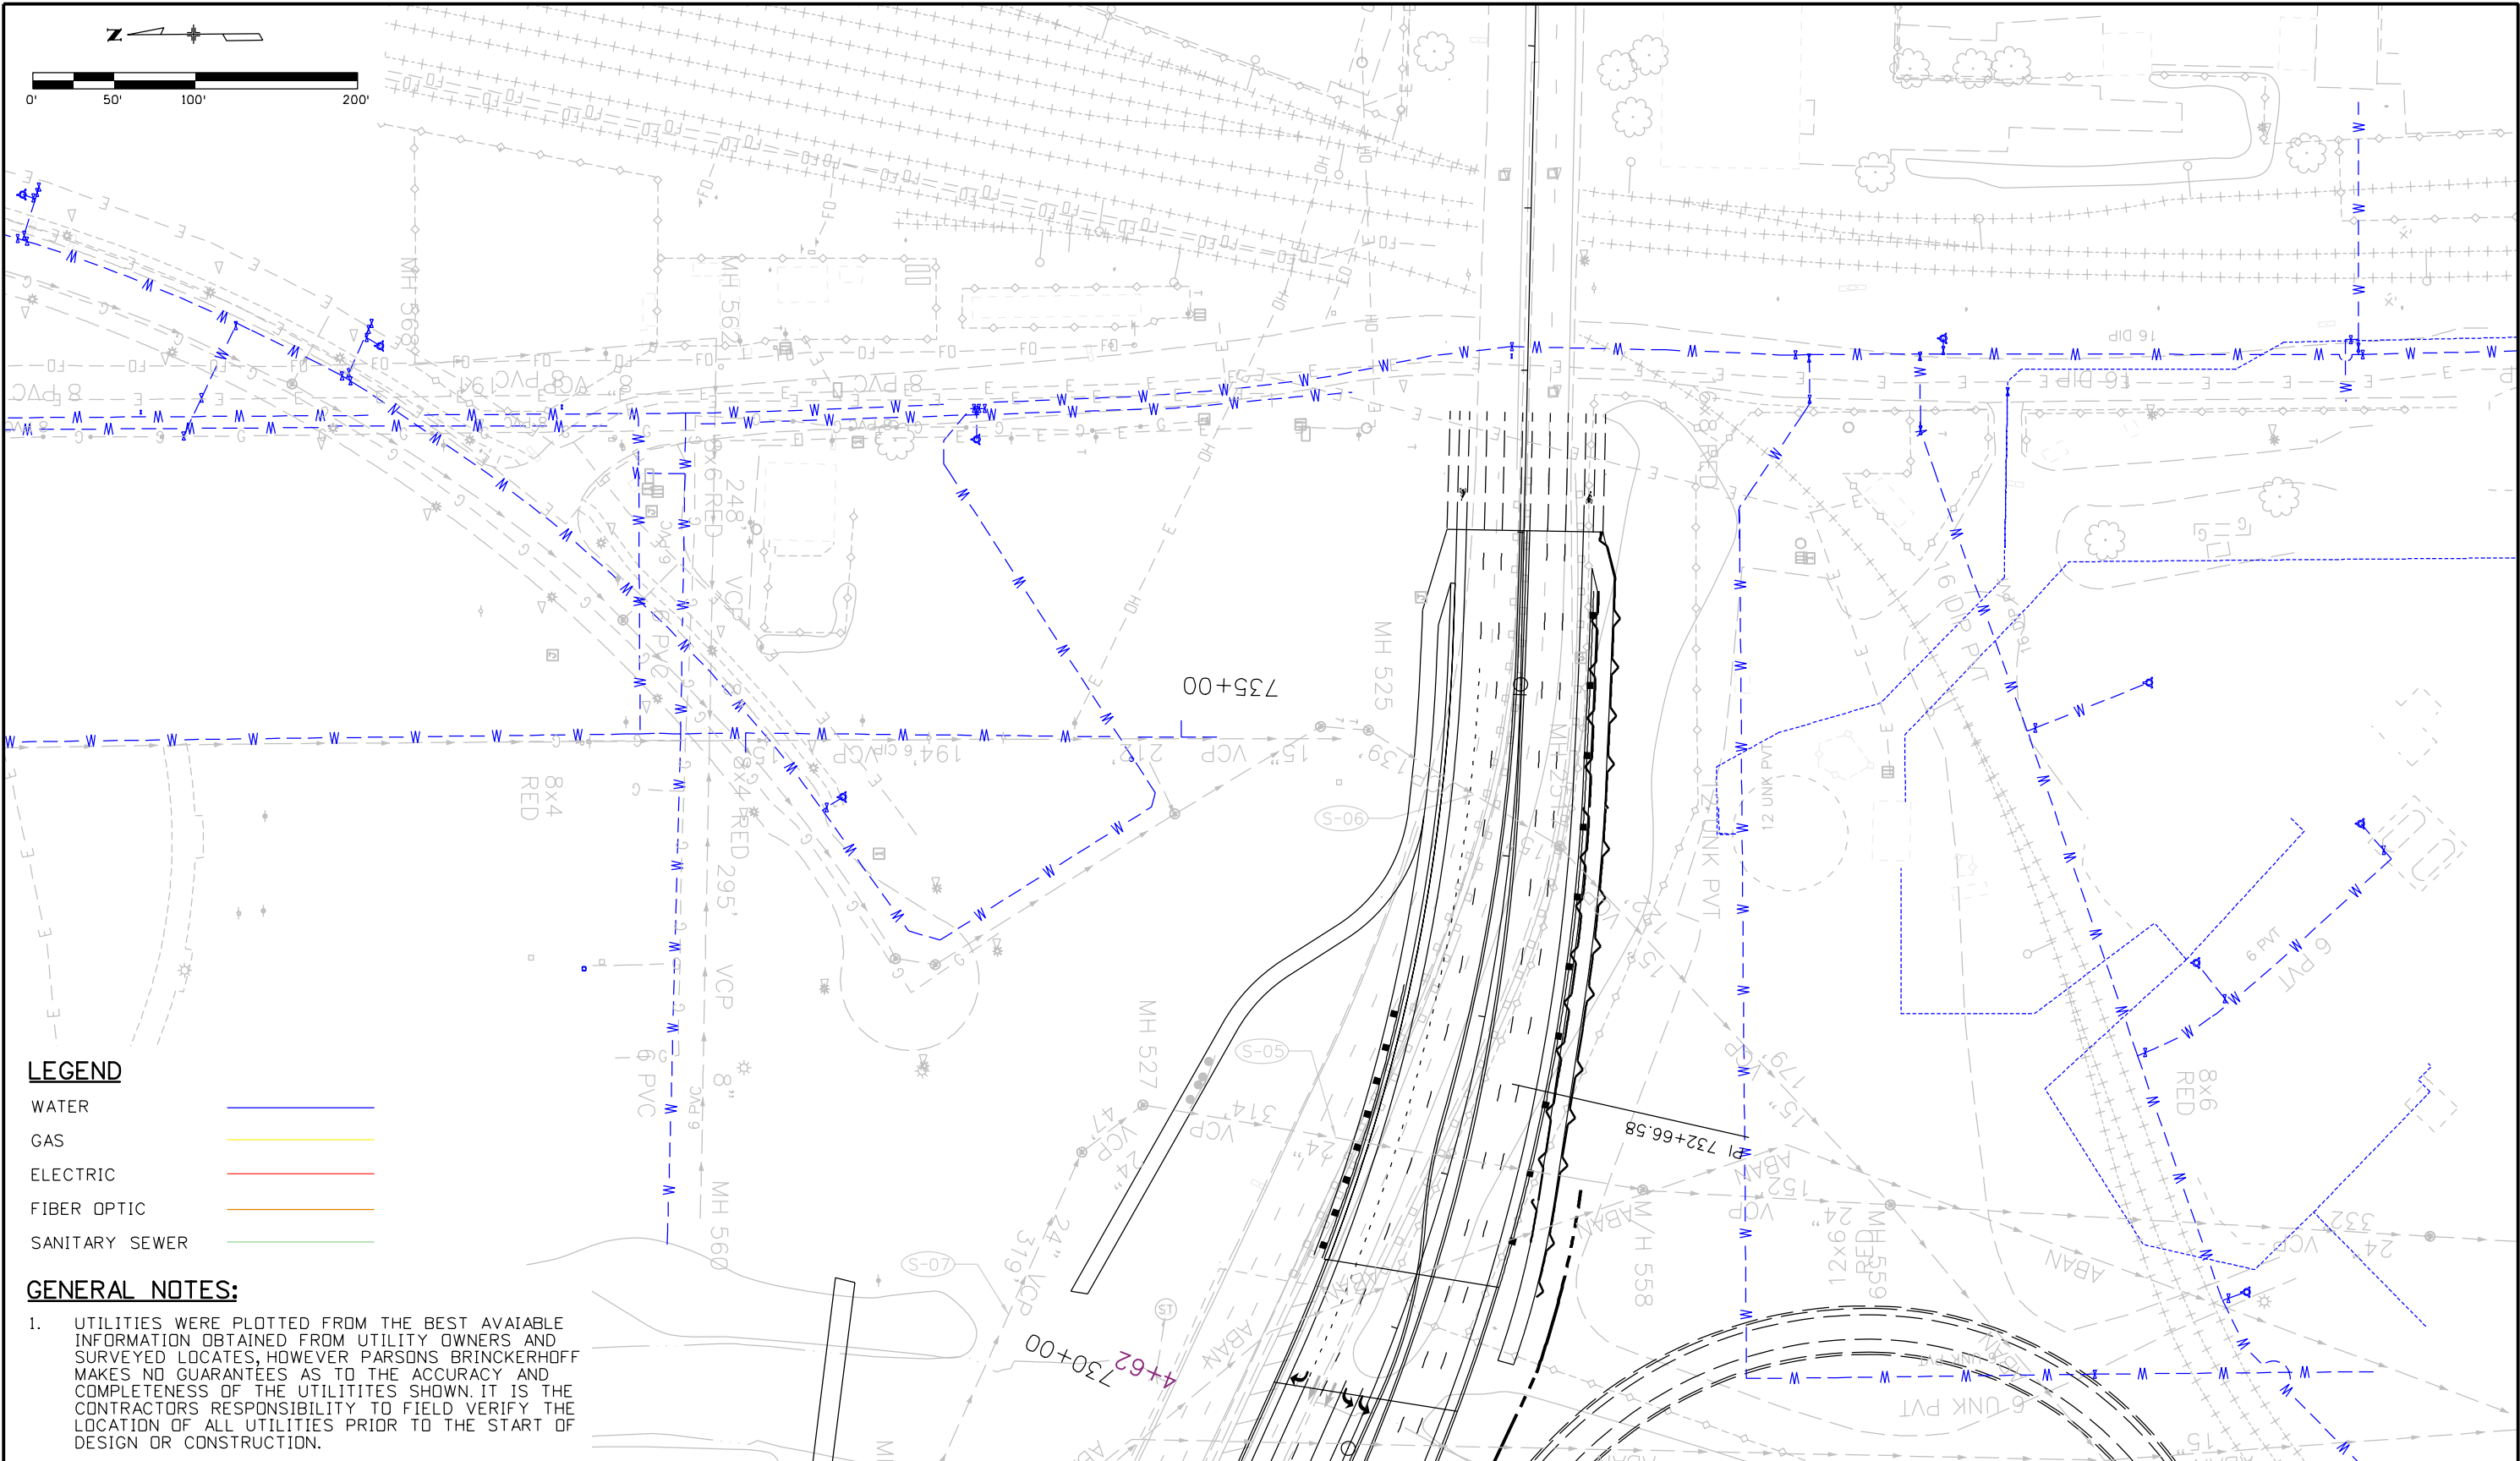


LEGEND

WATER	
GAS	
ELECTRIC	
FIBER OPTIC	
SANITARY SEWER	


GENERAL NOTES:


1. UTILITIES WERE PLOTTED FROM THE BEST AVAILABLE INFORMATION OBTAINED FROM UTILITY OWNERS AND SURVEYED LOCATES, HOWEVER PARSONS BRINCKERHOFF MAKES NO GUARANTEES AS TO THE ACCURACY AND COMPLETENESS OF THE UTILITIES SHOWN. IT IS THE CONTRACTORS RESPONSIBILITY TO FIELD VERIFY THE LOCATION OF ALL UTILITIES PRIOR TO THE START OF DESIGN OR CONSTRUCTION.


Print Date: 4/17/2014		Sheet Revisions			Colorado Department of Transportation		As Constructed		WATER		Project No./Code	
File Name: Water Sheet 3		Date:	Comments	Init.	 1480 Quail Lake Loop, Suite A Colorado Springs, CO 80906 Phone: 719-634-2323 FAX: 719-227-3298 Region 2		No Revisions:		SHEET 3 OF 7		IM 0252-423	
Horiz. Scale: 1:100 Vert. Scale:							Revised:		Designer: XXXXXXXX	Structure Numbers	19039	
Unit Information Unit Leader Initials							Void:		Detailer: XXXXXXXX		Sheet Number _ON	
 555 17th Street Suite 500 Denver, CO 80202					DMW		Subset: _SG		Subset Sheets: _SN of _SD			

Print Date: 4/17/2014		<div>R-X</div> <div></div> <div></div> <div></div>	Sheet Revisions			Colorado Department of Transportation			As Constructed		WATER SHEET 4 OF 7				Project No./Code	
File Name: Water Sheet 4			Date:	Comments	Init.	<div><div>1480 Quail Lake Loop, Suite A Colorado Springs, CO 80906 Phone: 719-634-2323 FAX: 719-227-3298</div></div> <div>Region 2DMW</div>			No Revisions:		Designer: XXXXXXXXStructure Detailer: XXXXXXXXNumbers Subset: _SGSubset Sheets: _SN of _SD				IM 0252-423	
Horiz. Scale: 1:100Vert. Scale:									Revised:							
Unit InformationUnit Leader Initials									Void:						19039	
<div>PARSONS BRINCKERHOFF</div> <div>555 17th Street Suite 500 Denver, CO 80202</div>															Sheet Number _ON	


PadillaK 3:26:27 PM pw: \\ABQPWINT01.wilsonco.com\Wilson_Projects\Documents\8100-TRN\CDOT\13-100-312-01\125_Cimarron_Interch\Utilities\Drawings\Water Sheet 5

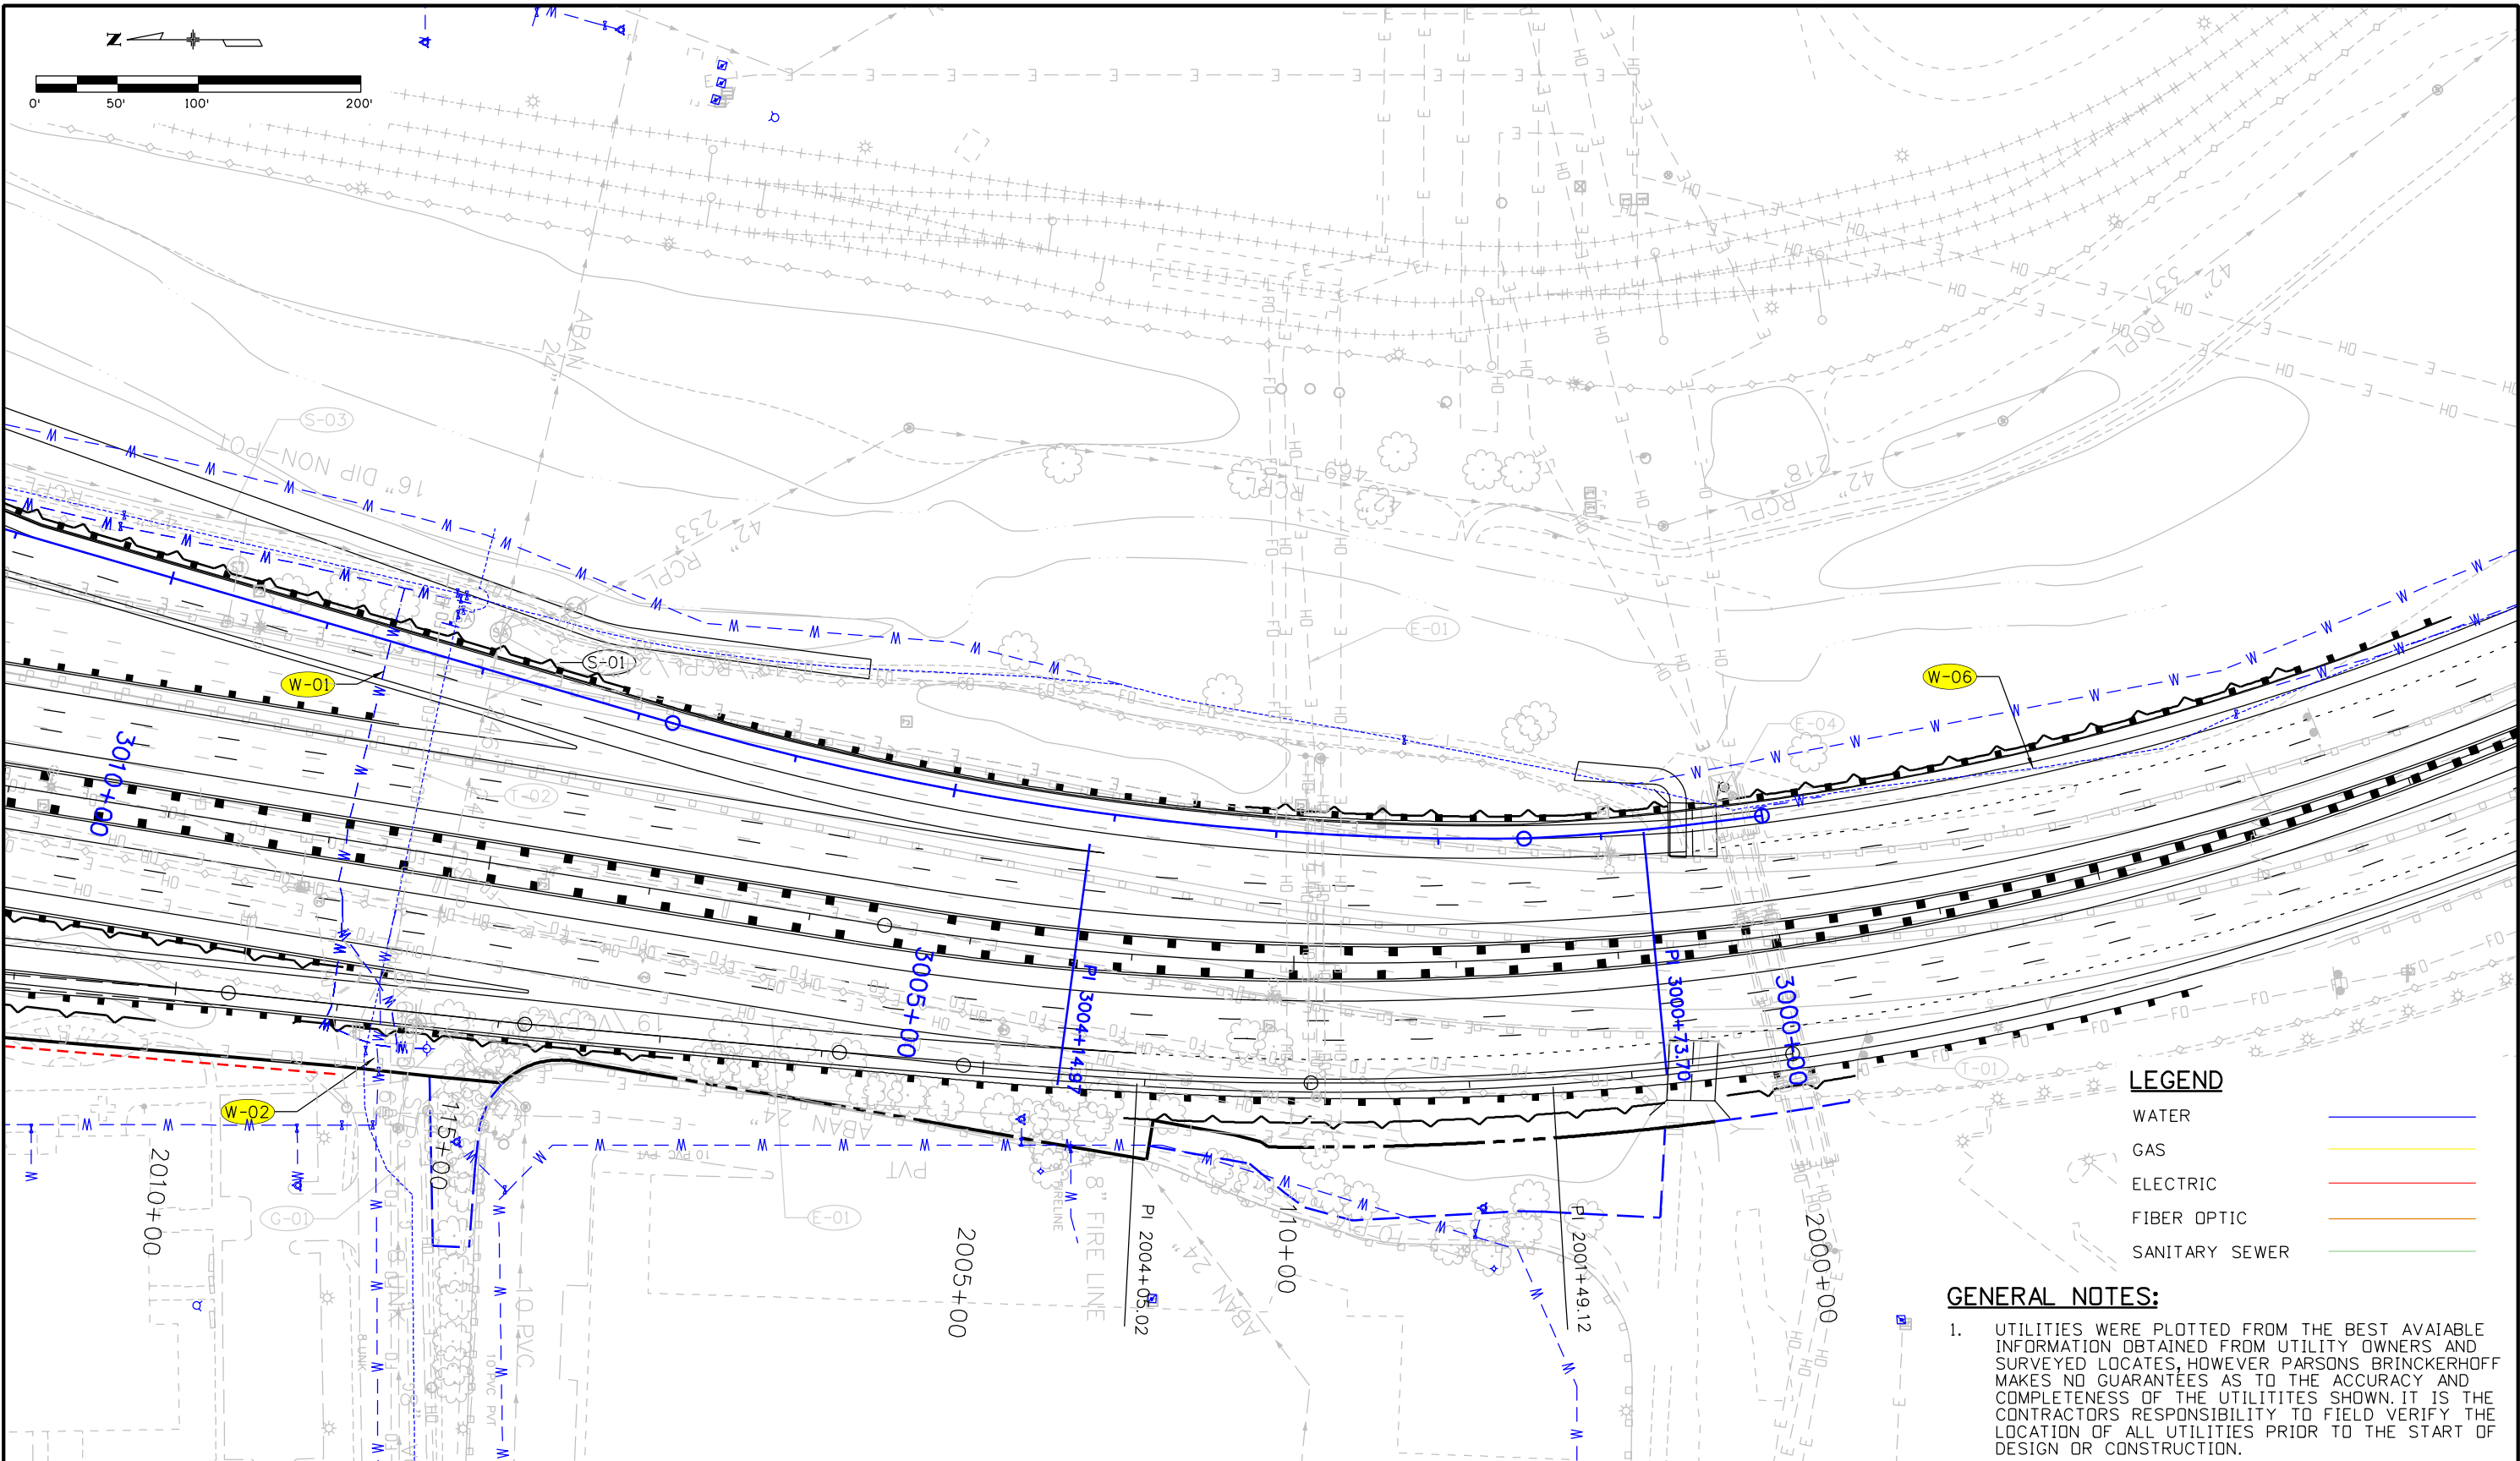


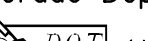Print Date: 4/17/2014		<div><div></div><div>R-X</div><div></div><div></div><div></div></div>	Sheet Revisions			<div><div>Colorado Department of Transportation</div><div>1480 Quail Lake Loop, Suite A Colorado Springs, CO 80906 Phone: 719-634-2323 FAX: 719-227-3298</div><div>Region 2DMW</div></div>		As Constructed	WATER SHEET 5 OF 7				Project No./Code	
File Name: Water Sheet 5			Date:	Comments	Init.			No Revisions:					IM 0252-423	
Horiz. Scale: 1:100Vert. Scale:								Revised:	Designer: XXXXXXXX	Structure Numbers	19039			
Unit InformationUnit Leader Initials								Void:	Detailer: XXXXXXXX					
<div><div>PARSONS BRINCKERHOFF</div><div>555 17th Street Suite 500 Denver, CO 80202</div></div>									Subset: _SG	Subset Sheets: _SN of _SD	Sheet Number _ON			

Print Date: 4/17/2014		<div><div>R-X</div><div></div><div></div><div></div></div>	Sheet Revisions			<div><div><div>Colorado Department of Transportation</div><div>1480 Quail Lake Loop, Suite A Colorado Springs, CO 80906 Phone: 719-634-2323 FAX: 719-227-3298</div><div>Region 2<div>DMW</div></div></div></div>		As Constructed	WATER SHEET 6 OF 7				Project No./Code	
File Name: Water Sheet 6			Date:	Comments	Init.			No Revisions:					IM 0252-423	
Horiz. Scale: 1:100 Vert. Scale:								Revised:	Designer: XXXXXXXX	Structure Numbers	19039			
Unit Information Unit Leader Initials								Void:	Detailer: XXXXXXXX					
<div><div><div>PARSONS BRINCKERHOFF</div></div><div>555 17th Street Suite 500 Denver, CO 80202</div></div>									Subset: _SG	Subset Sheets: _SN of _SD		Sheet Number _ON		

PadillaK 3:39:47 PM pw:\\ABQPWINT01.wilsonco.com\\Wilson_Projects\\Documents\\B100-TRN\\CDOT\\13-100-312-01_125_Cimarron_Interch\\19039\\Utilities\\Drawings\\Water Sheet 7

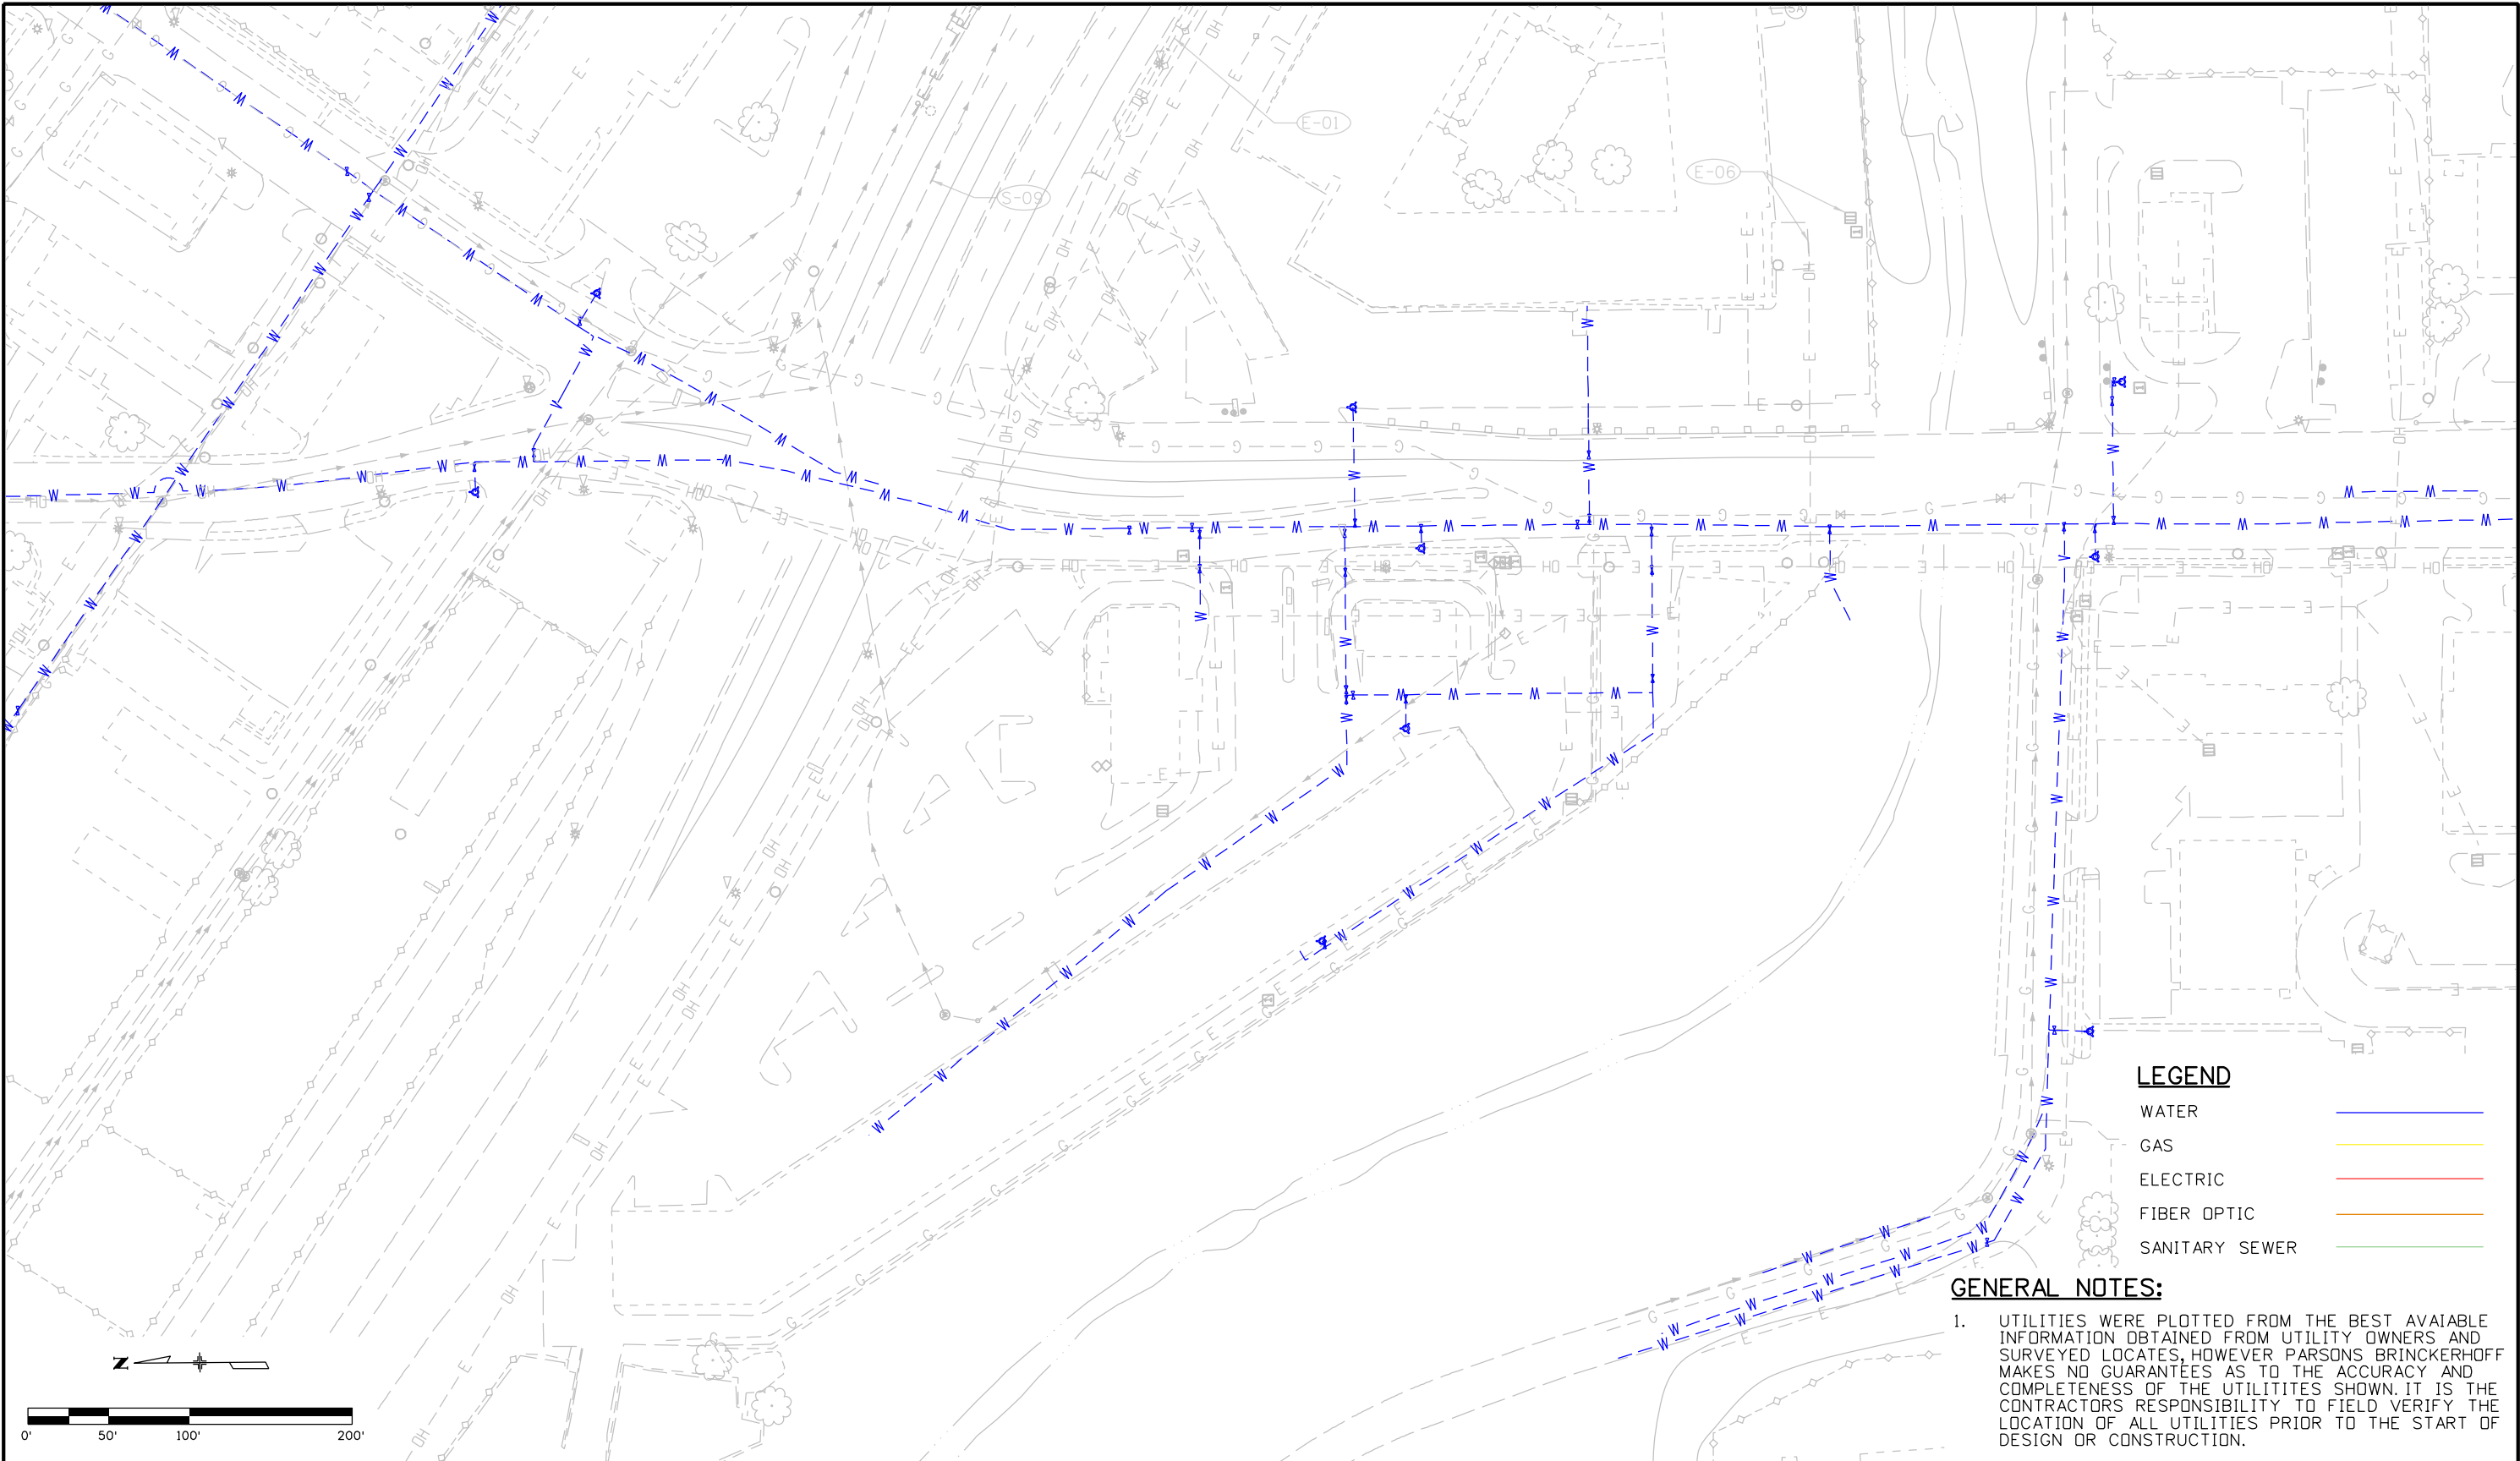

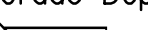Print Date: 4/17/2014		<div>R-X</div> <div></div> <div></div> <div></div>	Sheet Revisions			Colorado Department of Transportation			As Constructed		WATER SHEET 7 OF 7			Project No./Code	
File Name: Water Sheet 7			Date:	Comments	Init.	<div>1480 Quail Lake Loop, Suite A Colorado Springs, CO 80906 Phone: 719-634-2323 FAX: 719-227-3298</div> <div>Region 2DMW</div>			No Revisions:		Designer: XXXXXXXX Detailer: XXXXXXXX Subset: _SG Subset Sheets: _SN of _SD			IM 0252-423	
Horiz. Scale: 1:100 Vert. Scale:									Revised:					19039	
Unit Information Unit Leader Initials									Void:					Sheet Number	
<div><div>PARSONS BRINCKERHOFF</div><div>555 17th Street Suite 500 Denver, CO 80202</div></div>														_ON	